

MR-2003-170  
Turning Point Ministries -  
National Center for Youth Issues

ORDINANCE NO. 11493

AN ORDINANCE CLOSING AND ABANDONING A SEWER EASEMENT AND SEWER LINE ON A TRACT OF LAND LOCATED IN THE 6100 BLOCK OF PRESERVATION DRIVE, MORE PARTICULARLY DESCRIBED HEREIN AND AS SHOWN ON THE MAP ATTACHED HERETO AND MADE A PART HEREOF BY REFERENCE.

---

SECTION 1. BE IT ORDAINED BY THE CITY COUNCIL OF THE CITY OF CHATTANOOGA, TENNESSEE, That there be and is hereby closed and abandoned a sewer easement and sewer more particularly described below and as shown on the map attached hereto and made a part hereof by reference:

A sewer easement and sewer line on a tract of land located in the 6100 block of Preservation Drive. To find the point of beginning start at Man Hole #285 at +0.00 thence northeast 130 feet along Line 1 to the point of beginning thence continuing northeast along said line some 145.74 feet northeast to Man Hole #1 at 2+75.74 feet thence some 75 feet southwest on Line 1A to a point as shown on Microfiche 51850, As Built 03/21/1989, Contract #49B. Tax Map 129K-B-028 and 027.06.

SECTION 2. BE IT FURTHER ORDAINED, That this Ordinance shall take effect two (2) weeks from and after its passage, as provided by law.

PASSED on Third and Final Reading

\_\_\_\_\_ November 18 \_\_\_\_\_, 2003.

S/ \_\_\_\_\_  
CHAIRPERSON



APPROVED:  X  DISAPPROVED: \_\_\_\_\_

DATE: \_\_\_\_\_ November 24 \_\_\_\_\_, 2003

S/ \_\_\_\_\_  
MAYOR

Reviewed By: s/ \_\_\_\_\_  
*David Eichenthal*

/pm

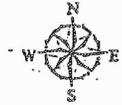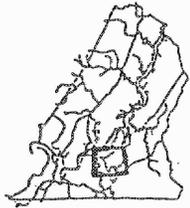


CHATTANOOGA

CASE NO: 2003-0170

PC MEETING DATE: 10/13/2003

MR: ABANDON SEWER LINE & EASEMENT

1 in. = 100.0 feet

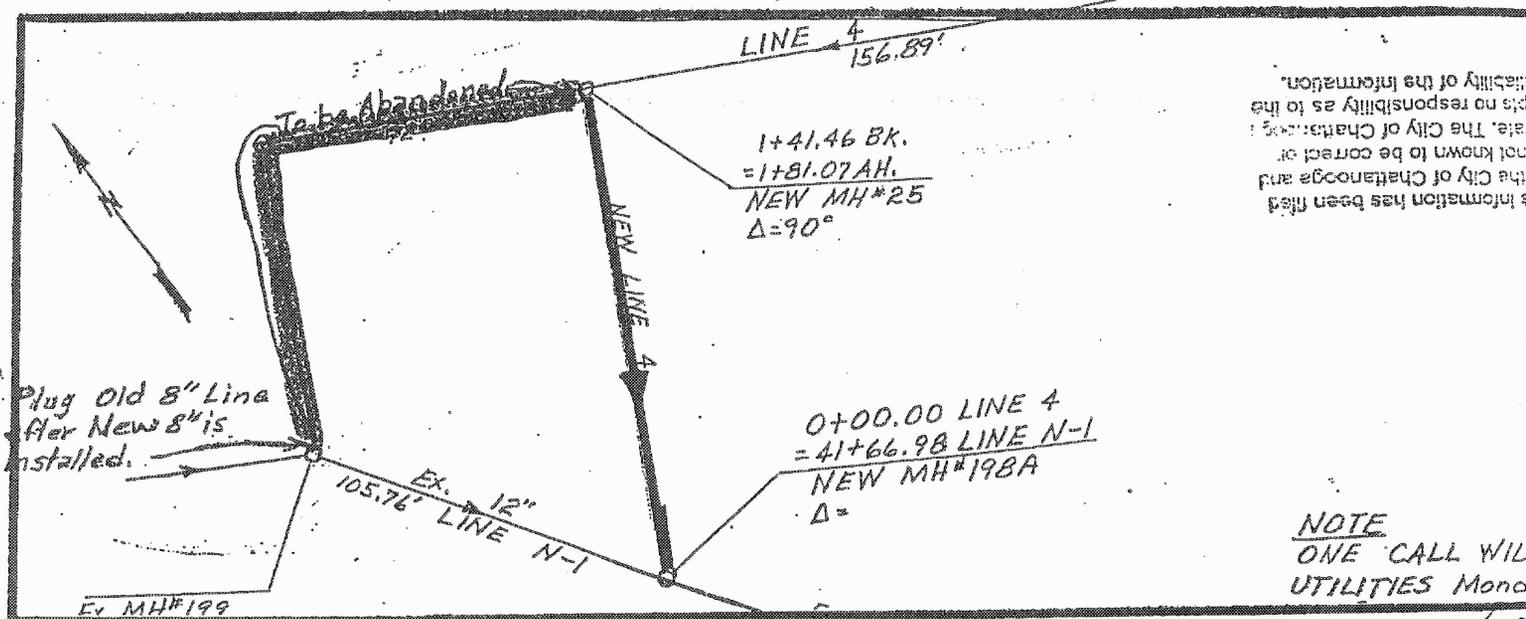

Information has been filed... The City of Chattanooga and... not known to be correct or... rate. The City of Chattanooga... no responsibility as to the... stability of the information.

**NOTE**  
 ONE CALL WILL  
 UTILITIES Monday

